

John Hallen

16'

U. S. DEPARTMENT OF TRANSPORTATION
FEDERAL HIGHWAY ADMINISTRATION
BUREAU OF PUBLIC ROADS
WASHINGTON, D. C.



**REASSEMBLY OF POINT PLEASANT BRIDGE
DOCUMENTATION OF STRUCTURAL DAMAGE
AND
IDENTIFICATION OF LABORATORY SPECIMENS**



By

Ernest G. Wiles

and

Jerar Nishanian

**STRUCTURES AND APPLIED MECHANICS DIVISION
OFFICE OF RESEARCH AND DEVELOPMENT**

July 1970

TG
470
.W55
1970

REASSEMBLY OF POINT PLEASANT BRIDGE
DOCUMENTATION OF STRUCTURAL DAMAGE AND IDENTIFICATION
OF LABORATORY SPECIMENS

Federal Highway Administration
Research Library
Turner-Fairbank Highway Research Ctr.
6300 Georgetown Pike
McLean, VA 22101

The Point Pleasant Bridge, often spoken of as the Silver Bridge, suddenly collapsed on the evening of December 15, 1967. The catastrophic failure of this structure that spanned the Ohio River at Point Pleasant, West Virginia, created many unique problems and posed many new questions to the bridge engineering profession. One question that was paramount was, "What caused the bridge to collapse?". Arrangements were made with the Corps of Engineers to perform rescue work and to clear the wreckage from the Ohio River channel as quickly as possible. It was decided that in order to facilitate the study of all possible causes of the failure an attempt should be made to reassemble the bridge, similar to investigations of aircraft accidents. Consequently, a 25-acre reassembly site was leased approximately two miles downstream from the bridge site on the West Virginia shore. Although the exposed wreckage was photographed and sketched to identify it as much as possible, the wreckage below water was more difficult to identify. The Corps of Engineers made available two derrick barges which operated on a 24-hour a day schedule to perform the rescue and salvage work. Assistance in this operation was

provided by divers working for the Dravo Corporation under contract with the Corps of Engineers. The divers found it impossible because of the darkness under water to identify the wreckage except by feel. Because of the need of getting the bodies of victims, and cargoes of trucks, removed as soon as possible, as well as to open the channel for river traffic, some of the bridge members had to be flame cut or broken off during salvage operations. A piece marking crew from the West Virginia Highway Department identified bridge members when they were being removed from the river by painting identifying marks on them. Figure 1 shows the two derrick barges engaged in salvage operations at the site of the collapse working in the area of the West Virginia side span. Barges were used in transporting the wreckage to the reassembly site where it was unloaded and stockpiled on the river bank.

The reassembly site was designed in such a way that the trusses and eyebar chains would be laid out on the ground separated by a gravel road simulating the bridge deck. Additional gravel roads were made so that cranes could pick up the steel from the stockpile on the bank and place it in the proper position on the ground. An aerial view of the reassembly site is shown in Figure 2. The eyebar chains can be distinguished in position on the ground. The north or upstream side of the bridge is nearest the river. The Ohio end of the bridge is at the left side

of the figure. Also the two towers can be seen partially reassembled in separate areas adjacent to the stockpile of salvaged material. The Ohio tower is the one at the right side of the picture. The hanger straps were also placed in a separate location for later identification. Most of the steel at the reassembly site was taken from the river and consisted of the West Virginia side span, the main span and part of the Ohio side span. The section of the bridge that fell on the Ohio bank was stockpiled on the Ohio shore.

Mr. William Domico, bridge engineer for the West Virginia State Roads Commission, was assigned the responsibility by the State to place the steel in its proper location.

During the time the steel was being salvaged, various groups and individuals visited the site to inspect the work. It was discovered that a few critical pieces had not been salvaged. Additional search activities were conducted in an attempt to recover them. Success occurred in locating the outboard piece from the fractured eye of eyebar No. 330, but the pin that had been in the eyebar chain at joint C13N was not recovered even though three separate dredging operations were conducted for that purpose.

During the time the State was laying out the steel at the reassembly site, various groups and individuals were invited to examine it.

Dr. Hechtman, under contract with the Federal Highway Administration, made several examinations. Mr. Scheffey,

Chairman of the Structural Analysis and Tests Working Group, decided that it was essential to identify and catalog the fractured bridge members and the types of fractures that had occurred from the layout at the bridge reassembly site. Consequently, personnel from the Bridges and Structures Specialty Group, Structures and Applied Mechanics Division, were dispatched to Point Pleasant, West Virginia, to perform such a task. The operation was like a giant jigsaw puzzle. Problems existed for determining where each piece fit because of the size of the area (approximately 300 feet by 1500 feet) and from the fact that pieces might be duplicated from two to four to eight times. To identify some of the pieces required a detailed scrutiny. Dimensions were carefully measured. Size and shape of gusset plates, numbers and rows of rivets, and other physical features were compared with a set of as-built drawings of the bridge to properly identify the pieces. Sometimes drip marks on the painted surface were used to indicate which was the top side of a member and at the same time might identify which end was which.

Each piece of steel that had been placed was examined to make sure it had been positioned properly and that pieces still missing in the puzzle were located and placed in positions by crane as shown in Figure 3.

Some problems experienced in identifying the pieces were caused by corrosion of the fractures, the inclement weather, the rank growth of grass and meadow flowers that grew up around the pieces, and the settlement of some of the heavier pieces into the soft ground. All of these problems were resolved to obtain the definite identification of main members of the bridge.

Because of the length of time involved between salvaging operations and identifying and placing steel at the reassembly site, the original identification markings on the steel became indistinguishable. Consequently, new identification numbers were painted on each piece. Pieces were numbered consecutively. The fractured ends of each piece were compared with the ends of the adjoining pieces. In cases where some doubt existed, other pieces that might possibly fit were either brought to the particular location and tried, or in some cases comparisons were made by tracing the outline of the fractured end on paper, photographing it or making a plaster cast of it. Where definite matching occurred between pieces, match marks were painted on the ends. In a few truss panels, it was impossible to identify the correct location for a diagonal, even though two or three were tried. In these instances, the duplicate diagonals were left in these locations and are shown on subsequent photographs and drawings that were made.

At the same time that this work was proceeding, photographs of completed sections were being taken from the platform of a giraffe approximately 30 feet above the steel at the reassembly site as shown in Figure 4. Photographs were taken at approximately 25 foot intervals along each truss. The elevated platform was positioned so that an overlap of approximately 40 percent between photographs was obtained. The 101 photographs obtained were later fitted together into two 25-foot long continuous strips and mounted on kraft paper to form a montage of each side of the bridge. Originals of the two montages are on file at the Fairbank Highway Research Station for reference with this report. In addition to the consecutive identification numbers that showed on the pieces, panel point identification figures and a yardstick for a scale were also put in place for each photograph. In this way each photograph could be clearly identified and the print could be enlarged so that the yardstick scales were the same size for each finished photograph. This adjustment was essential to care for any variations in the height of the giraffe platform and in the focus of the camera.

In addition, all of the fractures in the main chord members and in the chain were photographed at close range from two or more directions to show details. Later, the 476 detail photographs together with the two montages were laid out on a large table at the Fairbank Highway Research

Station and were used to help resolve questions that arose regarding the location of pieces at the reassembly site and the types of fractures that had occurred. Prints of each of these detail photographs are also on file at FHRS for reference with this report.

After the pieces had been positioned, line drawings were made of both the north and south truss and eyebar chain of the bridge. Lengths of each piece and the respective identification number are shown on these field drawings. This information together with information concerning the type of fracture were put together on 17 drawings numbered 1 through 17 and are included as part of this report.

The structural members that formed the floor system, although brought to the reassembly site, were not placed in position on the ground between the north and south trusses. However, Dr. Hechtman examined the floor beam connections in the main chord members to determine the kinds of action that occurred during collapse. The types of failures that occurred at the floor beam ends have been documented in Dr. Hechtman's November 8, 1968 report entitled "Further Examination and Cataloging of Fractures in Wreckage of Point Pleasant Bridge."

The reassembly site was visited from time to time by various members of the Structural Analysis and Tests Working Group and by others invited to inspect the wreckage. Information obtained by some of these was used to identify and place the steel in correct positions or to give expert

opinions concerning fractures or details. In addition to some already named in this report, some of the others who visited the site were Captain William C. Foster of the National Transportation Safety Board, Mr. J. G. Lutz of J. E. Greiner Company, Professor W. L. Starkey of the Ohio State University, Mr. J. A. Bennett of the National Bureau of Standards, Mr. G. W. Steele and Mr. H. B. Hood, Jr., of the State Road Commission of West Virginia, Messrs. F. M. Masters, Jr., and L. C. Bellanca of Modjeski and Masters, Mr. Harold Mindlin of Battelle Memorial Institute Columbus Laboratories, and Mr. William M. Thatcher of American Bridge Company of United States Steel Corporation.

Certain pieces of the bridge were selected by the Structural Analysis and Tests Working Group and shipped to various research groups for further detail examinations and tests. Sometimes complete eyebars or complete joints were selected for this purpose. At other times, only small pieces of a member were selected. The location of the pieces are shown on the 17 drawings together with a code to identify to which laboratory they were sent.

Two of the shorter eyebars from panel U_0-U_1 , nominal length 25 feet 4 inches, one of which had been selected by the Bridges and Structures Group for full scale testing at the National Bureau of Standards, together with pins and spacer rings, were taken by Modjeski and Masters and sent to Lehigh University for tests. A list of these pieces is shown on Drawing No. 1.

Material originally sent to some laboratories such as the National Bureau of Standards in some instances was subsequently divided up and sent to other laboratories for tests. Only the original disposition of the material is shown on the drawings. Subsequent dispositions are described in file letters and other reports.

Information from reports by Dr. Hechtman regarding fractures and other salient details were used for correlating information obtained by the Bridges and Structures Specialty Group and for inclusion on the drawings.

The critically fractured and badly bent hanger box at joint U13N together with both ends of hanger U13C13 were identified at the reassembly site and sent to the Fairbank Highway Research Station for further examination, as shown on the line drawings of Drawing No. 3. Sections of the joints between the hanger box and the top chord were removed by flame cutting and sent to the National Bureau of Standards for tests.

This cataloging of information of the reassembly of the Point Pleasant Bridge together with the documentation of structural damage and identification of laboratory specimens will be used to provide Mr. C. F. Scheffey, Chairman, Structural Analysis and Tests Working Group, with additional information for inclusion in his final report to the National Transportation Safety Board on the Point Pleasant Bridge Investigation.

LIST OF FIGURES

1. Derrick barges engaged in salvage operations in the area of West Virginia side span.
2. An aerial view of the reassembly site.
3. Crane engaged in reassembly operations; positioning a fractured member in its proper position.
4. Photographs being taken of the reassembled bridge pieces.



Figure 1 - Derrick barges engaged in salvage operations in the area of West Virginia side span.

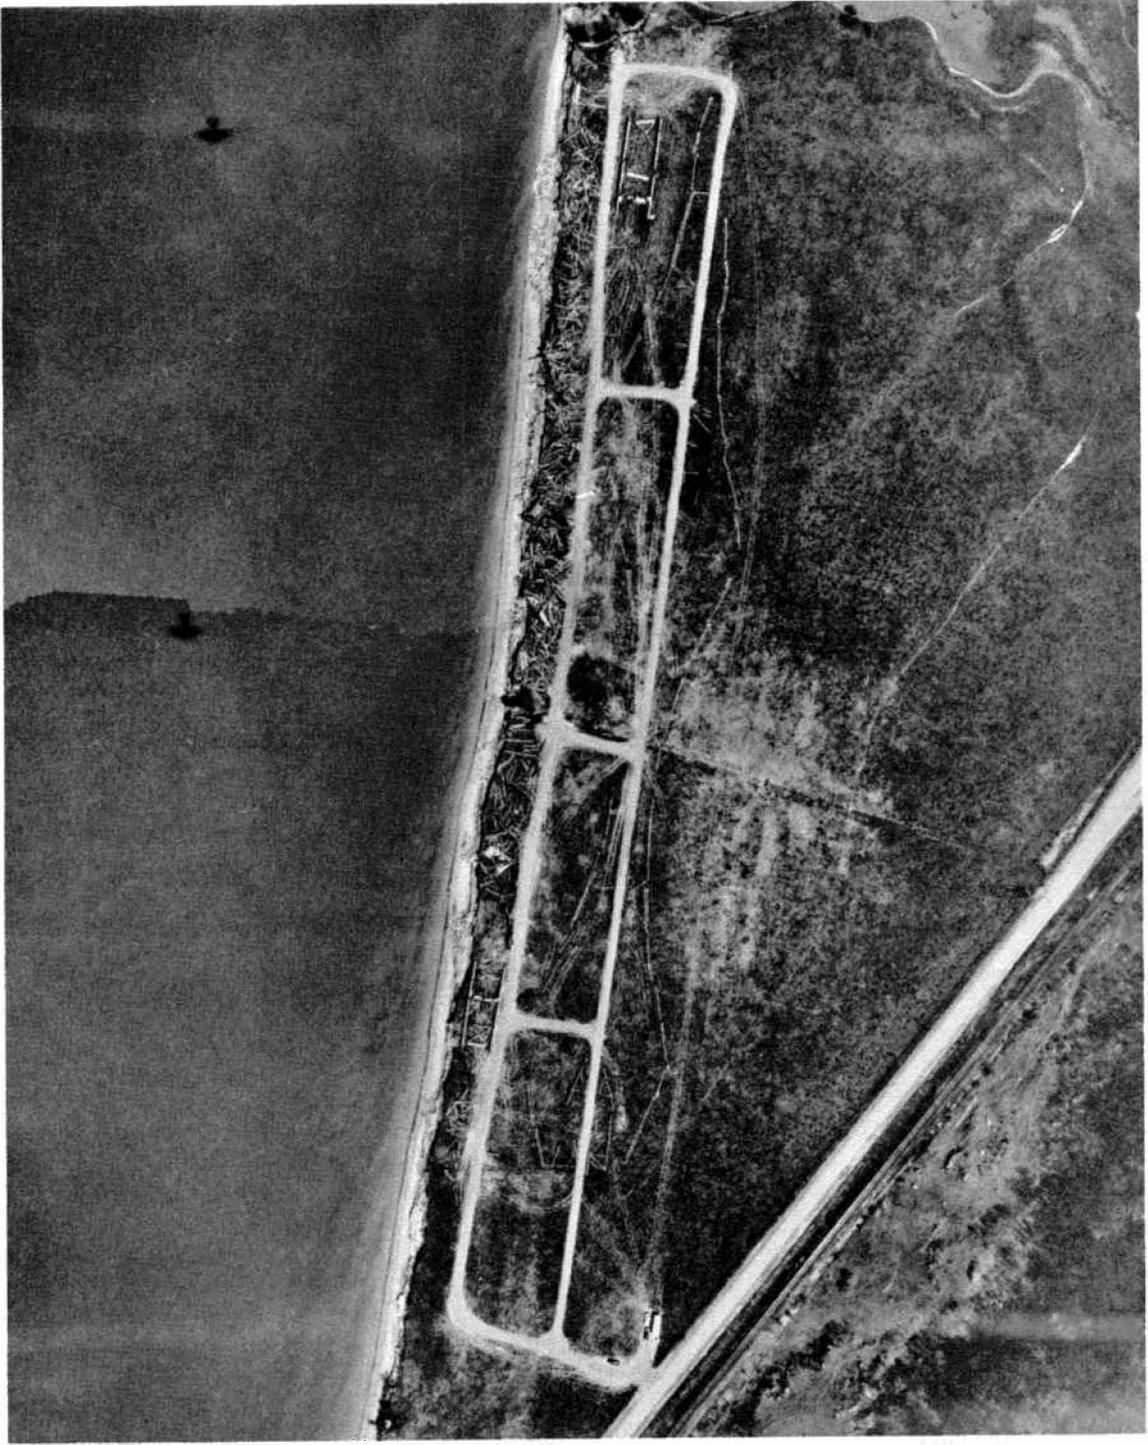


Figure 2 - An aerial view of the reassembly site.

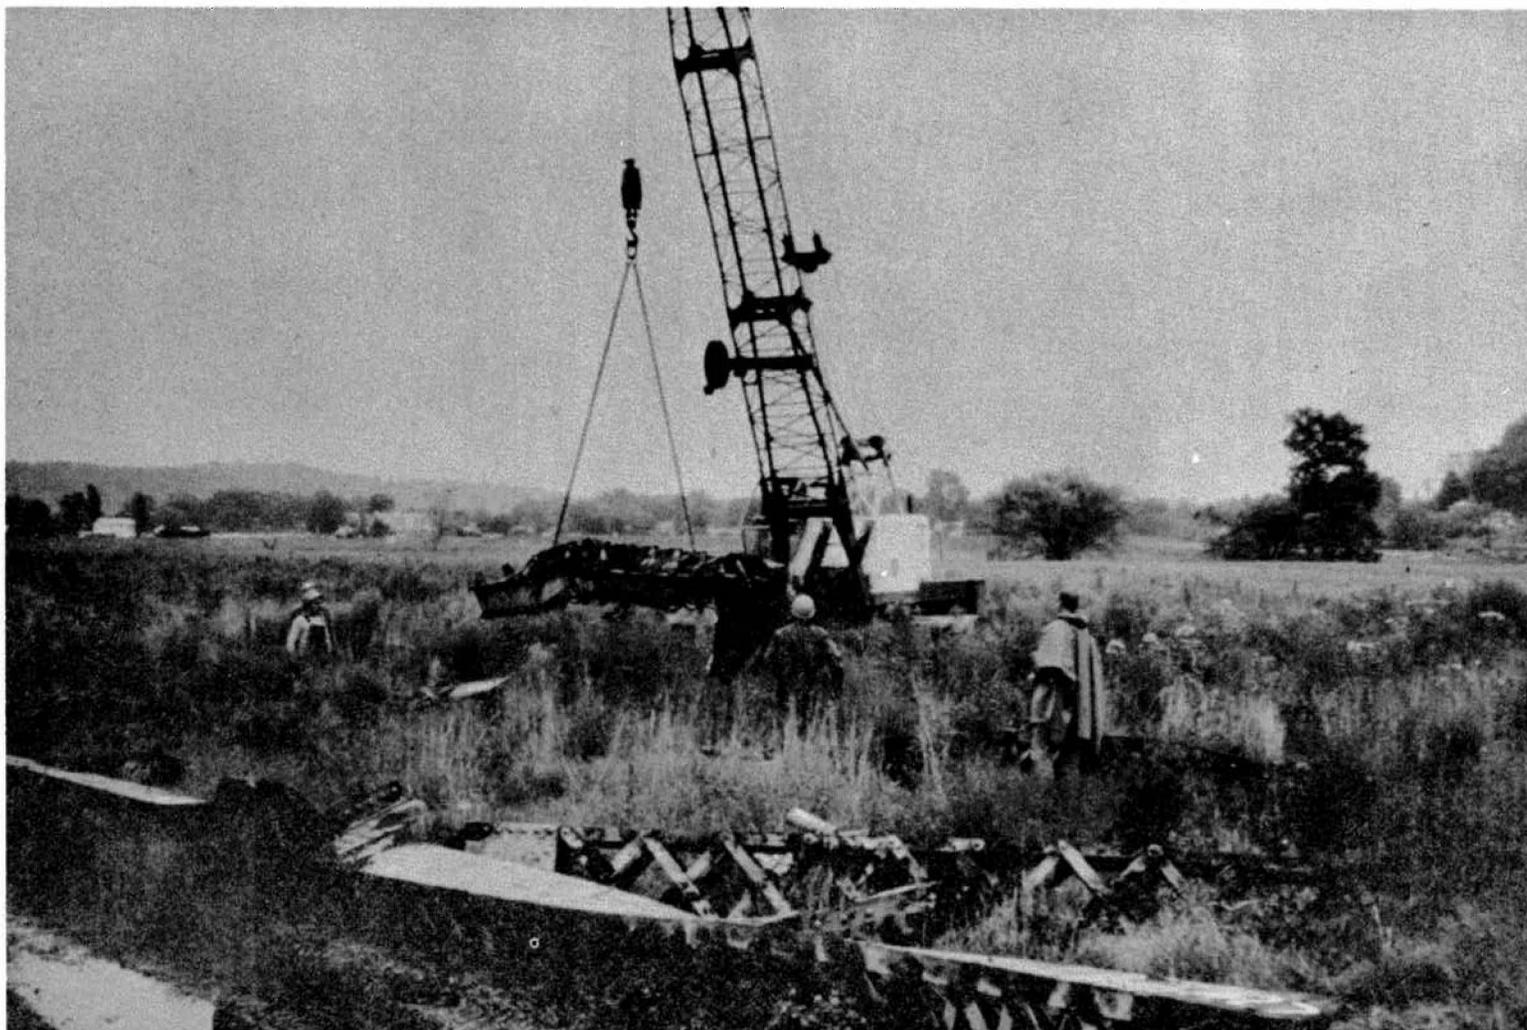


Figure 3 - Crane engaged in reassembly operations; positioning a fractured member in its proper position.



Figure 4 - Photographs being taken of the reassembled bridge pieces.

NOTES

- 1 All measurements of fracture locations to nearest foot.
- 2 Samples prefixed with "H" are those selected by R. A. Hechtman and shipped to NBS. Samples prefixed "HH" are those selected by R. A. Hechtman and shipped to BPR.

NOTATION

- FC - Flame Cut
 CL - Cleavage
 SH - Shear
 CS - Cleavage and Shear
 ⊙ Positive Match Point
 BPR ○ Shipped to BPR (1st ship)
 BPR ⊙ Shipped to BPR (2nd ship)
 NBS △ Shipped to NBS
 USS □ Shipped to USS
 BTL ⬡ Shipped to BATTELLE

MISCELLANEOUS SAMPLES

Samples selected and shipped to Fritz Engineering Laboratory by Modjeski & Masters

- 1 Eyebar 25'-4" ± c. c. pin holes, yellow point number 11 with original 1 1/2" diameter pin assembled in one end.
- 2 Eyebar 25'-4" ± c. c. pin holes, yellow point number 10, also numbered MM36
- 3 2 pins 1 1/2" diameter, 1'-1 1/2" long with 4" ring on each.
- 4 Pin 1 1/2" diameter, 1'-5 1/2" long with 3" ring
- 5 Pin 1 1/2" diameter, 1'-5 7/8" long, no ring

MISCELLANEOUS SAMPLES

Gusset Plate U₃ S BPR ○ HH2
 Gusset Plate U₃ S S.R. BPR ○ HH3

[Upper end of chain bent post
 L₀ U₀ N. side Ohio end NBS △
 [Short section of 2 eyebars
 8' ± and 15' ± long NBS △

[Three pins, all the same length that would fit in joint C₁₃
 [Two pins include hanger plate NBS △

Eyebar 51'-4 3/4" c. c. pin holes, numbered MM32, NBS △

Eyebar 51'-4 3/4" c. c. pin holes, numbered M31, NBS △

Eyebar 51'-4 3/4" c. c. pin holes, numbered 50, MM15 NBS △

Eyebar 44'-4 3/4" c. c. pin holes, numbered MM10, NBS △

Retainer cap and bolt BPR ○ HH4, unidentified

MISCELLANEOUS SAMPLES

Eyebar heads from Ohio shore wreckage

From eyebar designated as MM11, BTL ⬡

From eyebar designated as #3, BTL ⬡ & BTL ⬡

From eyebar designated as #5, BTL ⬡ & BTL ⬡

From eyebar designated as #7, BTL ⬡ & BTL ⬡

From eyebar designated as MM14, BTL ⬡

From eyebar designated as MM7, BTL ⬡

From eyebar designated as MM18, BTL ⬡



LOCATION KEY


TRUSS AND EYEBAR REASSEMBLY WITH FRACTURE NOTES AND SAMPLE LOCATIONS

Appendix A



NORTH TRUSS
LOCATION KEY

WRECKAGE IN THIS AREA
INSPECTED AND DOCUMENTED
WHERE IT FELL ON OHIO SHORE

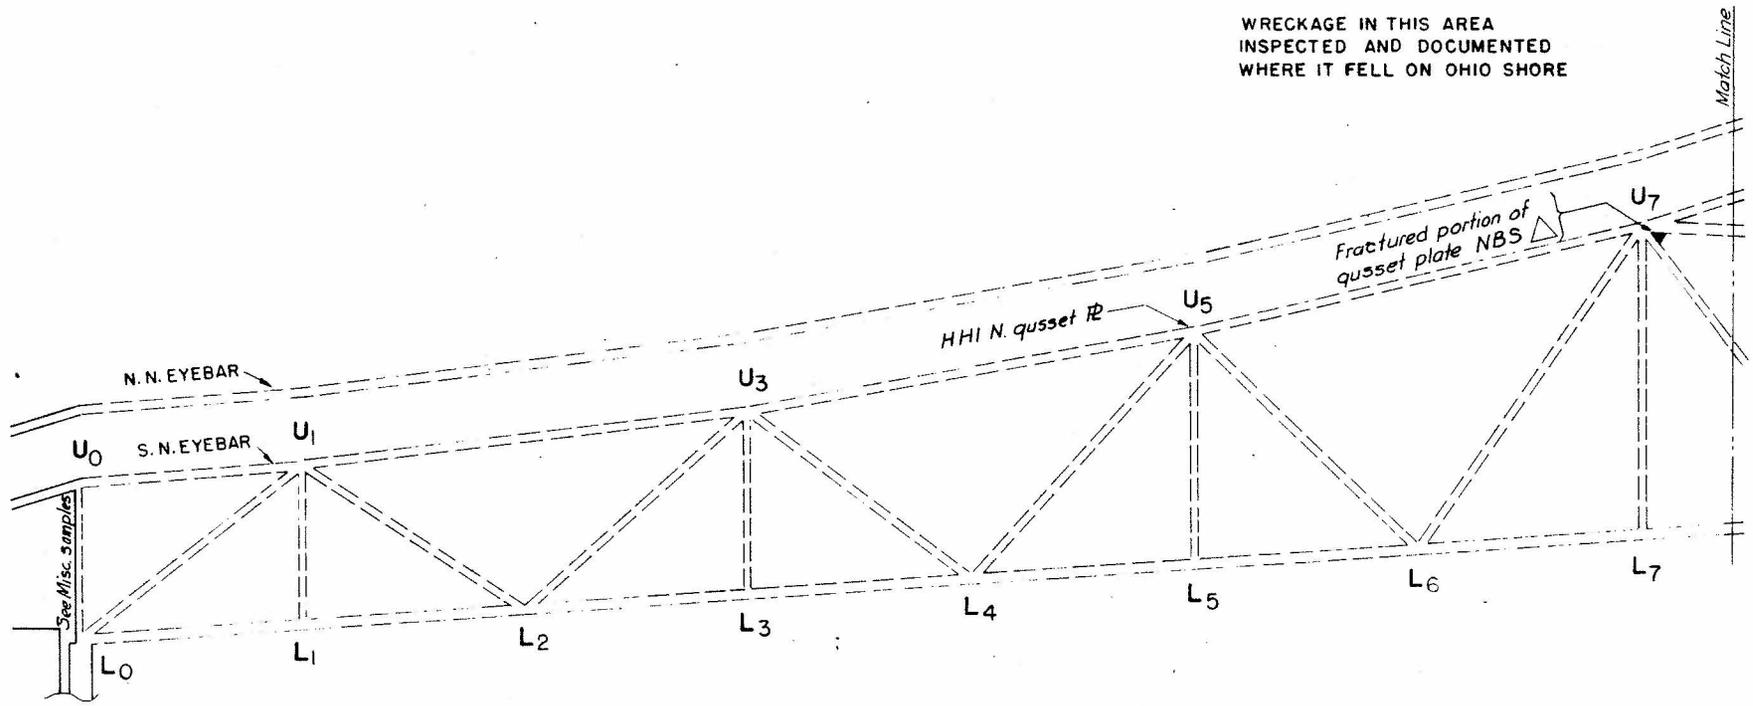

OHIO


WEST VA.



NORTH TRUSS
LOCATION KEY


WRECKAGE IN THIS AREA
INSPECTED AND DOCUMENTED
WHERE IT FELL ON OHIO SHORE

WRECKAGE AT
REASSEMBLY SITE

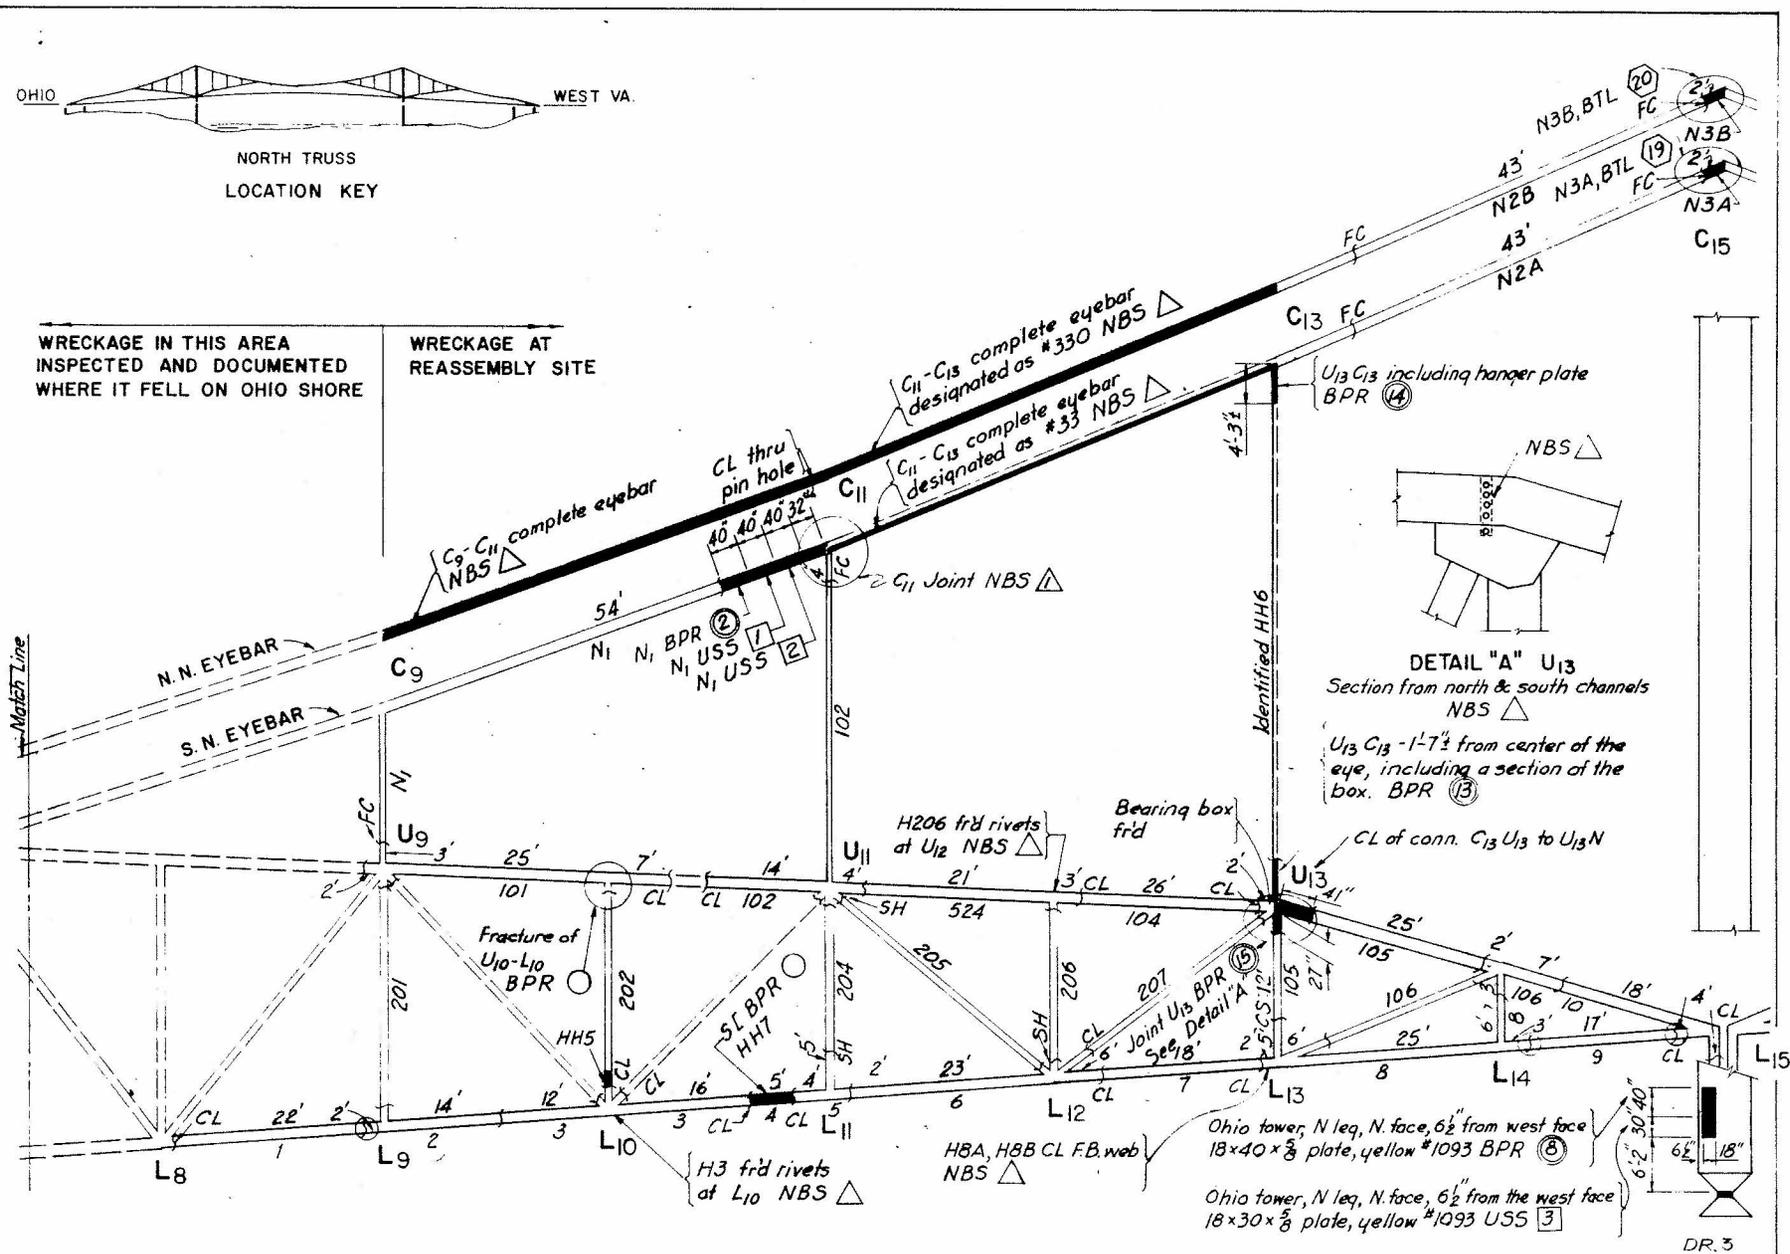




NORTH TRUSS
LOCATION KEY

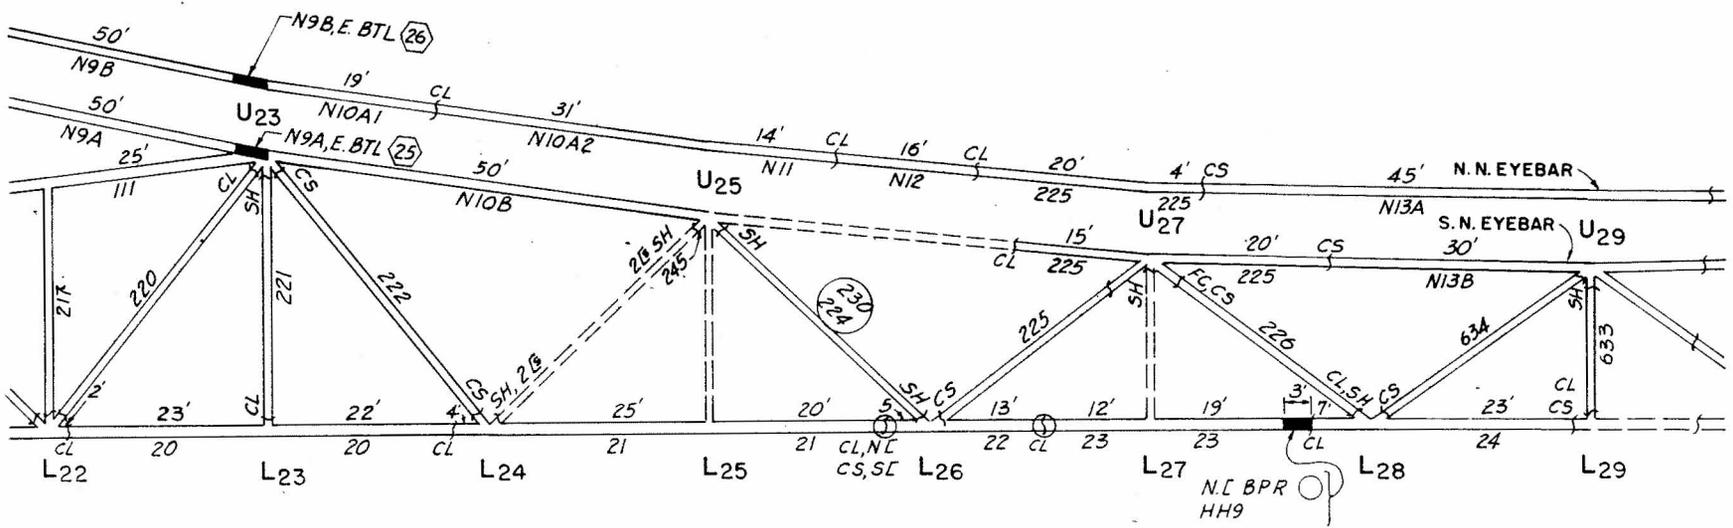




NORTH TRUSS
LOCATION KEY

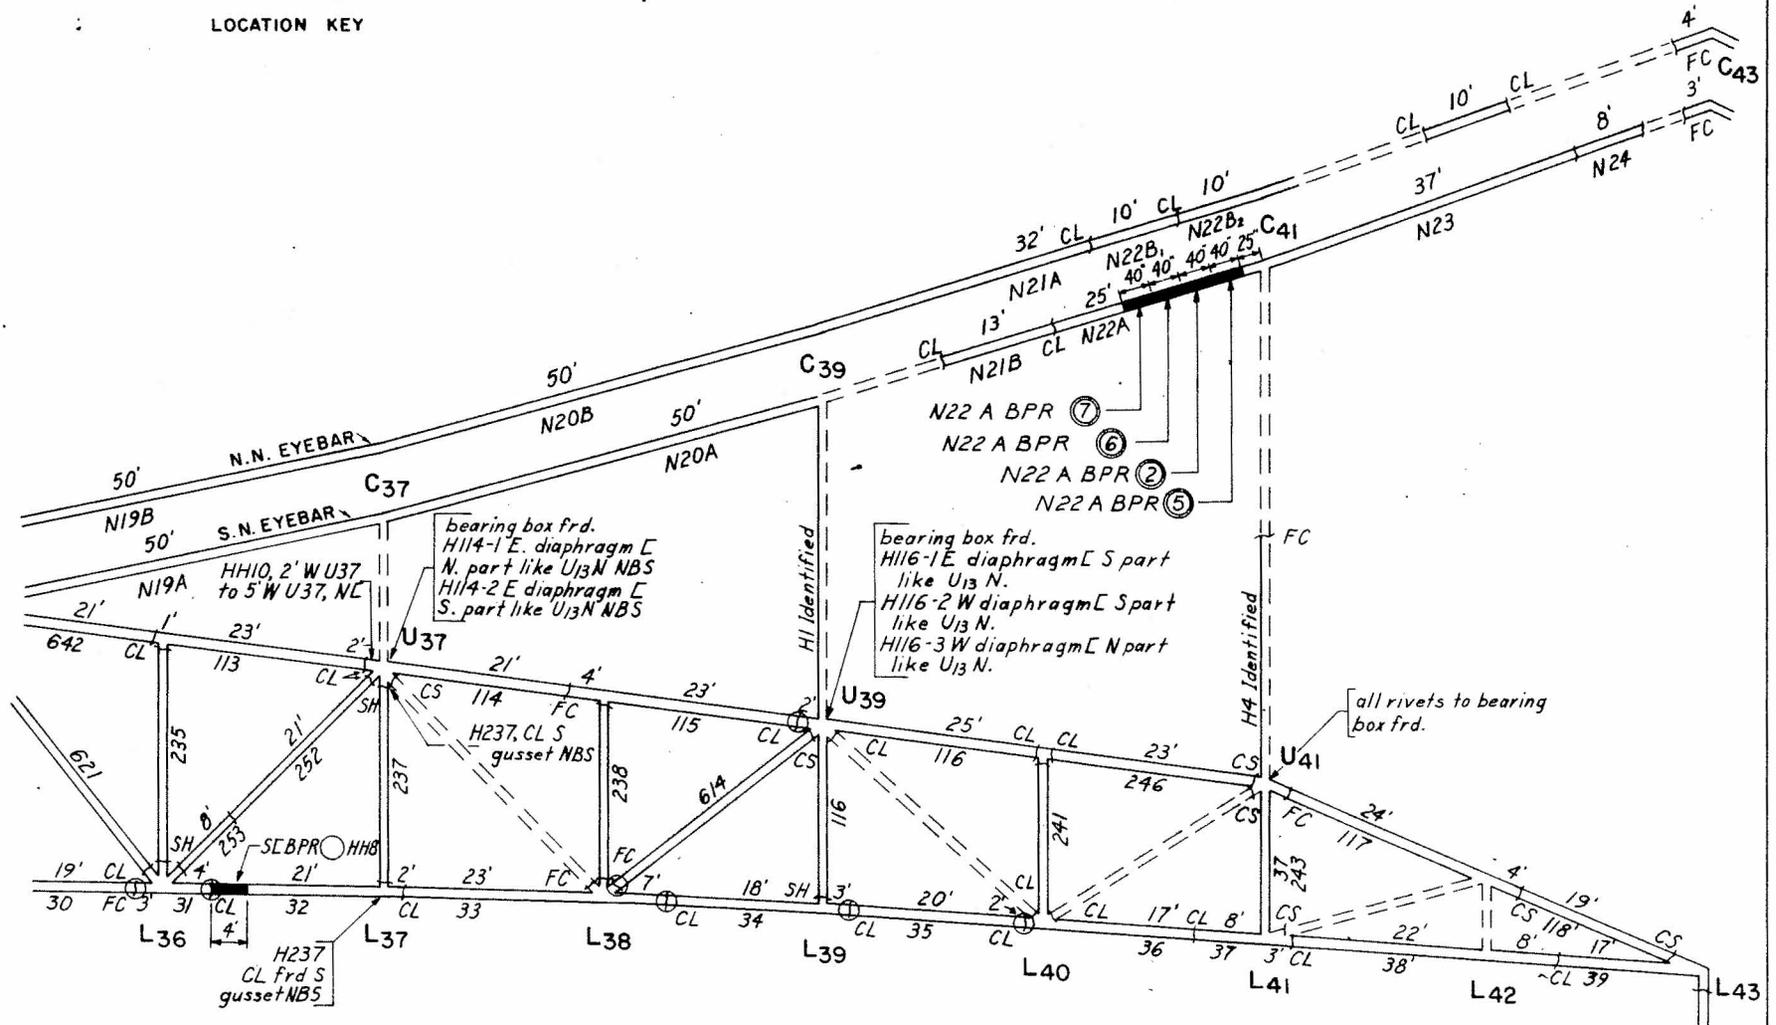



NORTH TRUSS
LOCATION KEY

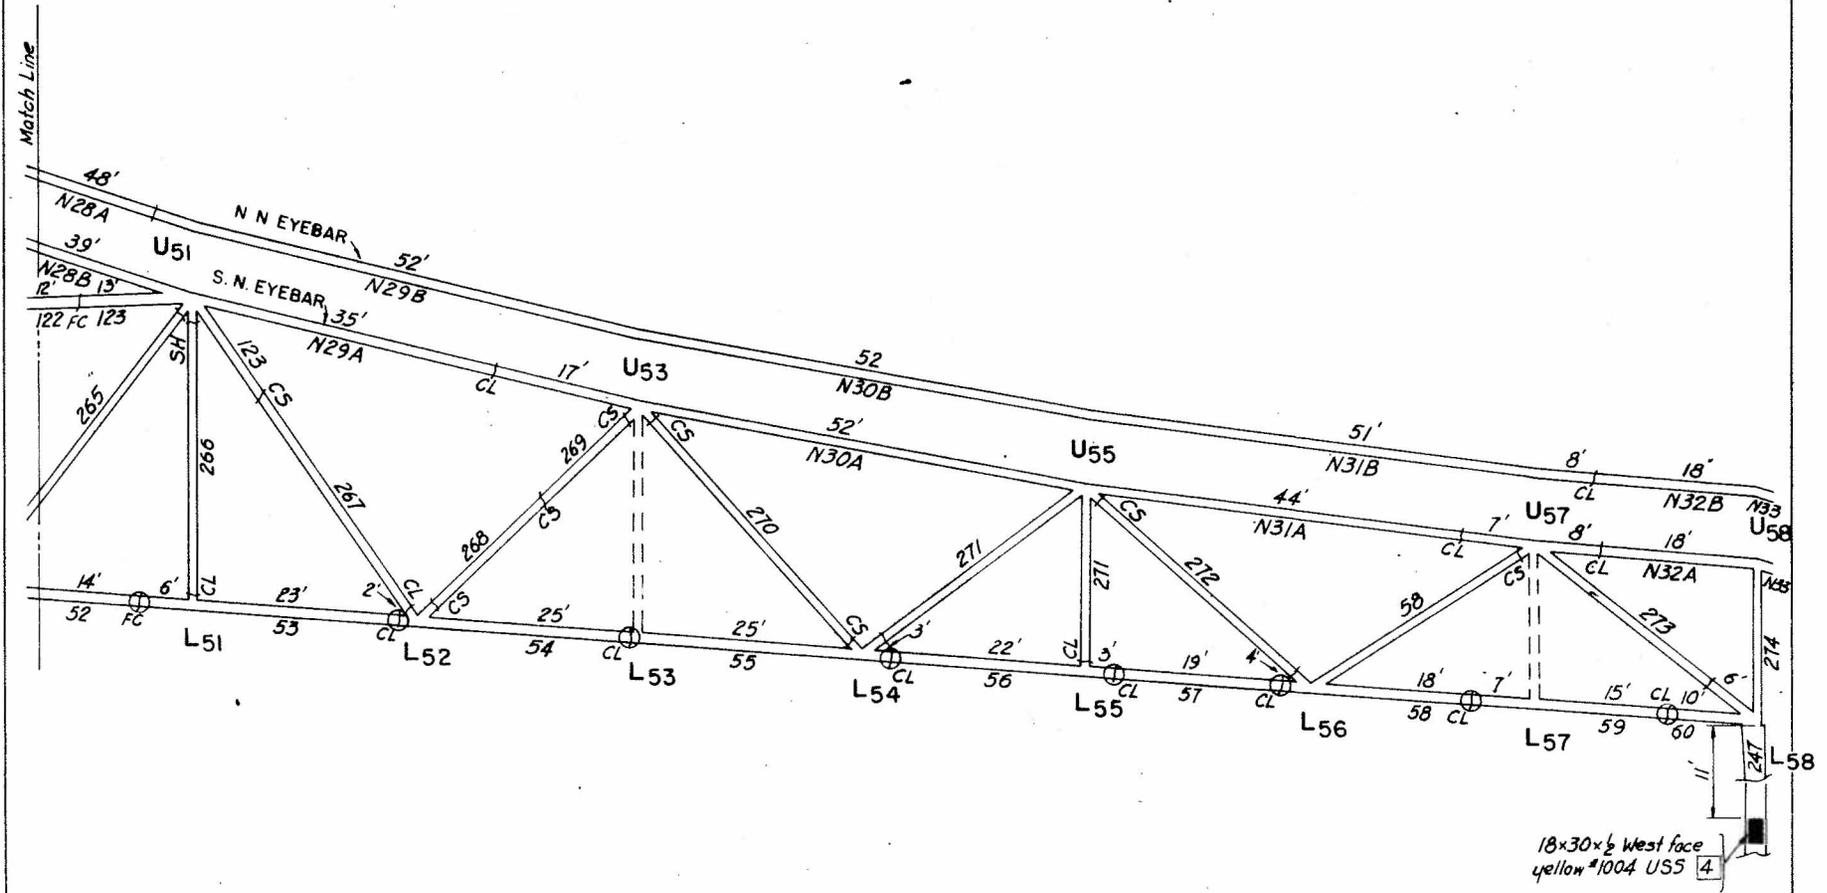

OHIO


WEST VA.



SOUTH TRUSS
LOCATION KEY

WRECKAGE IN THIS AREA
INSPECTED AND DOCUMENTED
WHERE IT FELL ON OHIO SHORE

Match Line

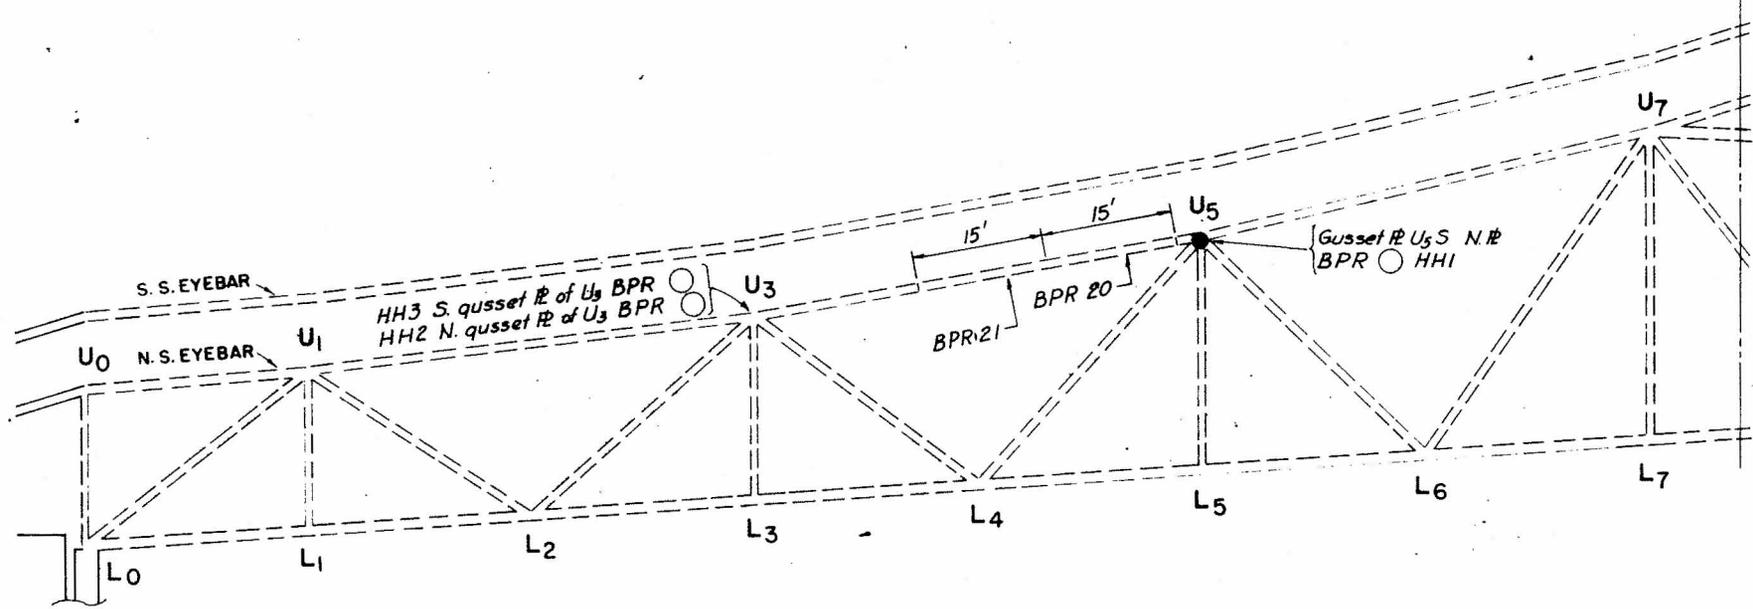



SOUTH TRUSS
LOCATION KEY

